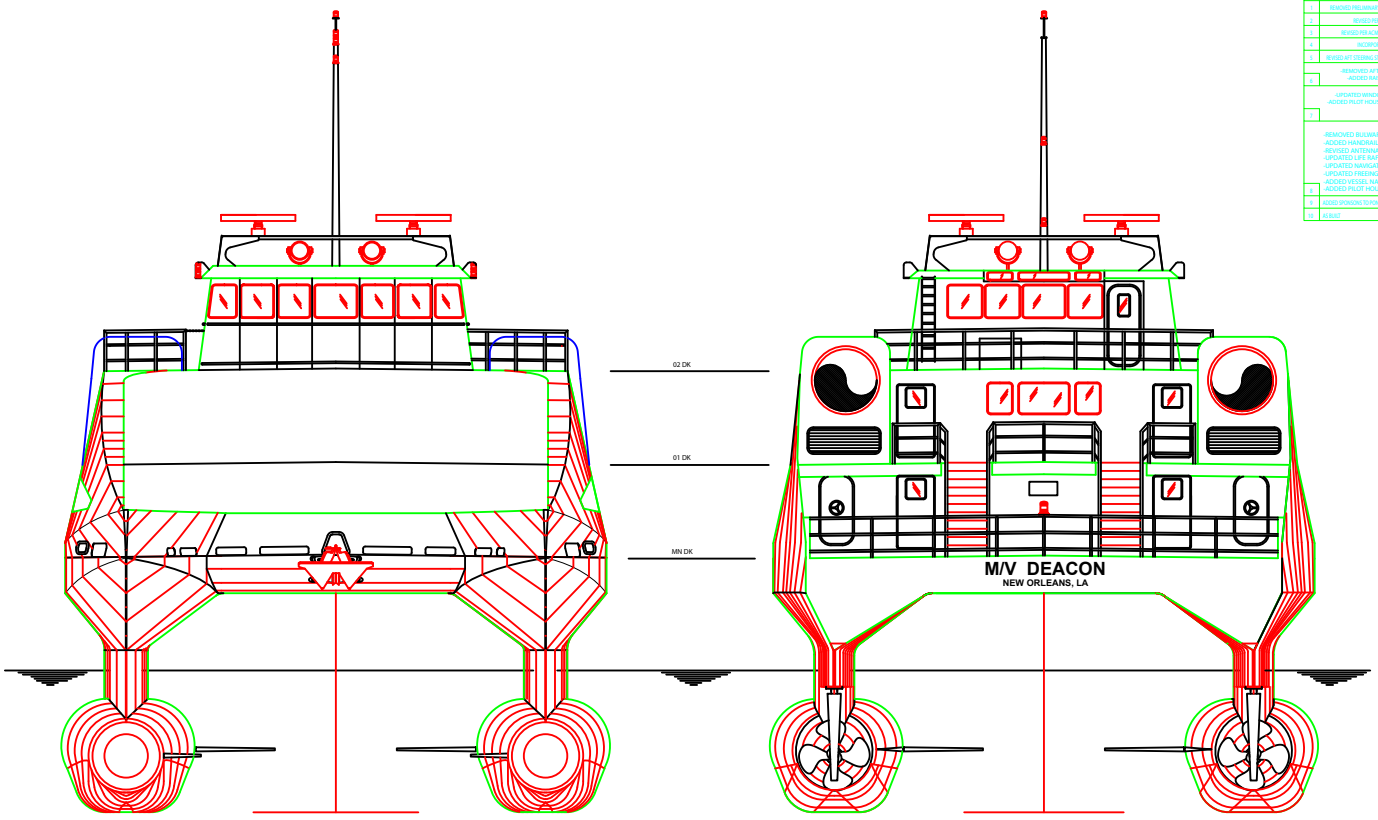

FORWARD END ELEVATION

AFT END ELEVATION

AS BUILT