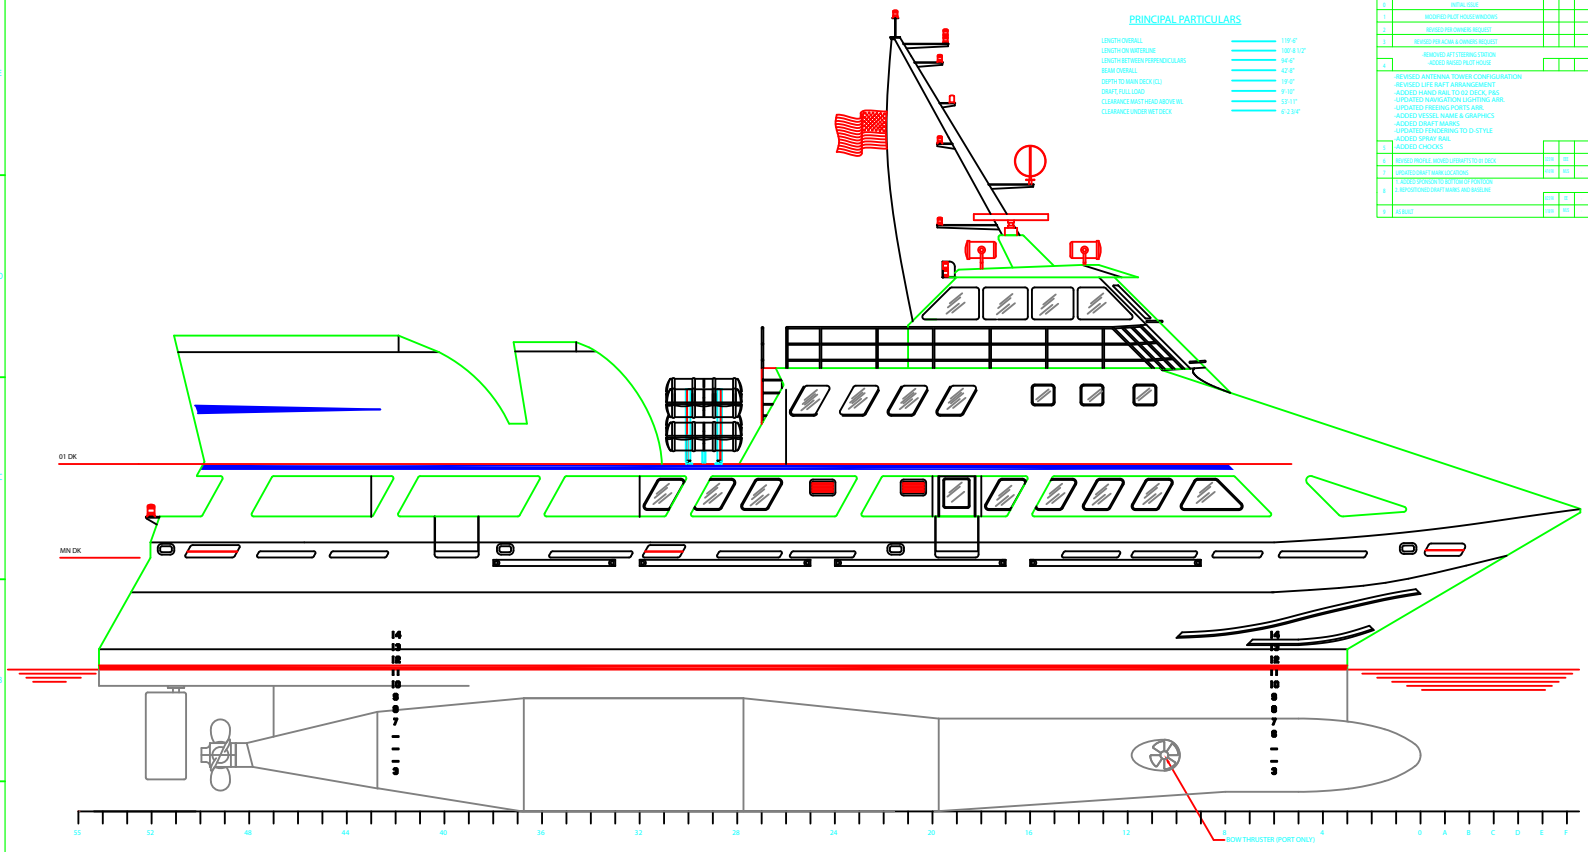

PRINCIPAL PARTICULARS

LENGTH OVERALL	119'-6"
LENGTH ON WATERLINE	110' 6 1/2"
LENGTH BETWEEN PERPENDICULARS	94'-6"
BEAM OVERALL	42'-6"
DEPTH TO MAIN DECK (CL)	19'-3"
DRAFT, FULL LOAD	8'-10"
CLEARANCE MAST HEAD ABOVE WL	123'-1"
CLEARANCE UNDER WET DECK	6'-2 3/4"

REVISIONS

REV	DESCRIPTION	DRAWN	CHK'D	APP'D	DATE
0	INITIAL ISSUE				
1	MODIFIED PILOT HOUSE WINDOWS				
2	REVISED PER OWNERS REQUEST				
3	REVISED PER ACMA & OWNERS REQUEST				
4	REMOVED AFT STEERING STATION ADDED RAISED PILOT HOUSE				
5	REVISED ANTENNA TOWER CONFIGURATION -REVISED LIFE RAFT ARRANGEMENT -ADDED HAND RAIL TO 01 DECK, PAS -UPDATED NAVIGATION LIGHTING ARR. -UPDATED FIREING POINTS ARR. -ADDED VESSEL NAME & GRAPHICS -ADDED DRAFT MARKS -UPDATED FENDERING TO D-STYLE ADDED SPRAY RAIL ADDED CHOCKS				
6	REVISED PROFILE, MOVED LIFERAFTS TO 01 DECK	DLC	RH		
7	UPDATED DRAFT MARK LOCATIONS	DLC	MH		
8	1. ADDED SPONSON TO BOTTOM OF PONTOON 2. REPOSITIONED DRAFT MARKS AND BASELINE	DLC	MH		
9	AS BUILT	DLC	MH		

AS BUILT

TRICO MARINE OPERATORS, INC.

ALAN C. McCLURE ASSOCIATES, INC.
NAVAL ARCHITECTS MARINE ENGINEERS
2600 S. GESSNER, STE. 500, HOUSTON,TEXAS 77063

250 PASSENGER SWATH
GENERAL ARRANGEMENT
OUTBOARD PROFILE

DRAWN	CHK'D	APP'D	DATE	DRAWING NUMBER	REV
DLC	RH		04-17-07	3043-1 040-000	9